

BUILT BY  
**KCI** Kelley's Controls, Inc.  
 210 E. 57th St. / P.O. BOX 13807  
 ODESSA, TEXAS 79768-3807  
 (432) 362-7998

DRAWING # TARG-D-007-01    WORK ORDER # 3498A

REFERENCE DRAWINGS:

NO.	DATE	REVISION	DRW.	DES.	CHK.	APP.	NO.	DATE	REVISION	DRW.	DES.	CHK.	APP.
							0	7/20/15	AS BUILT	JDC			




REAGAN COMPRESSOR STATION  
 SADN-3482  
 PANEL LAYOUT

SCALE: NONE    PLOT SCALE:

A/E:    LOCATION:

DWG. NO: TARG-D-007-01    REV. 0



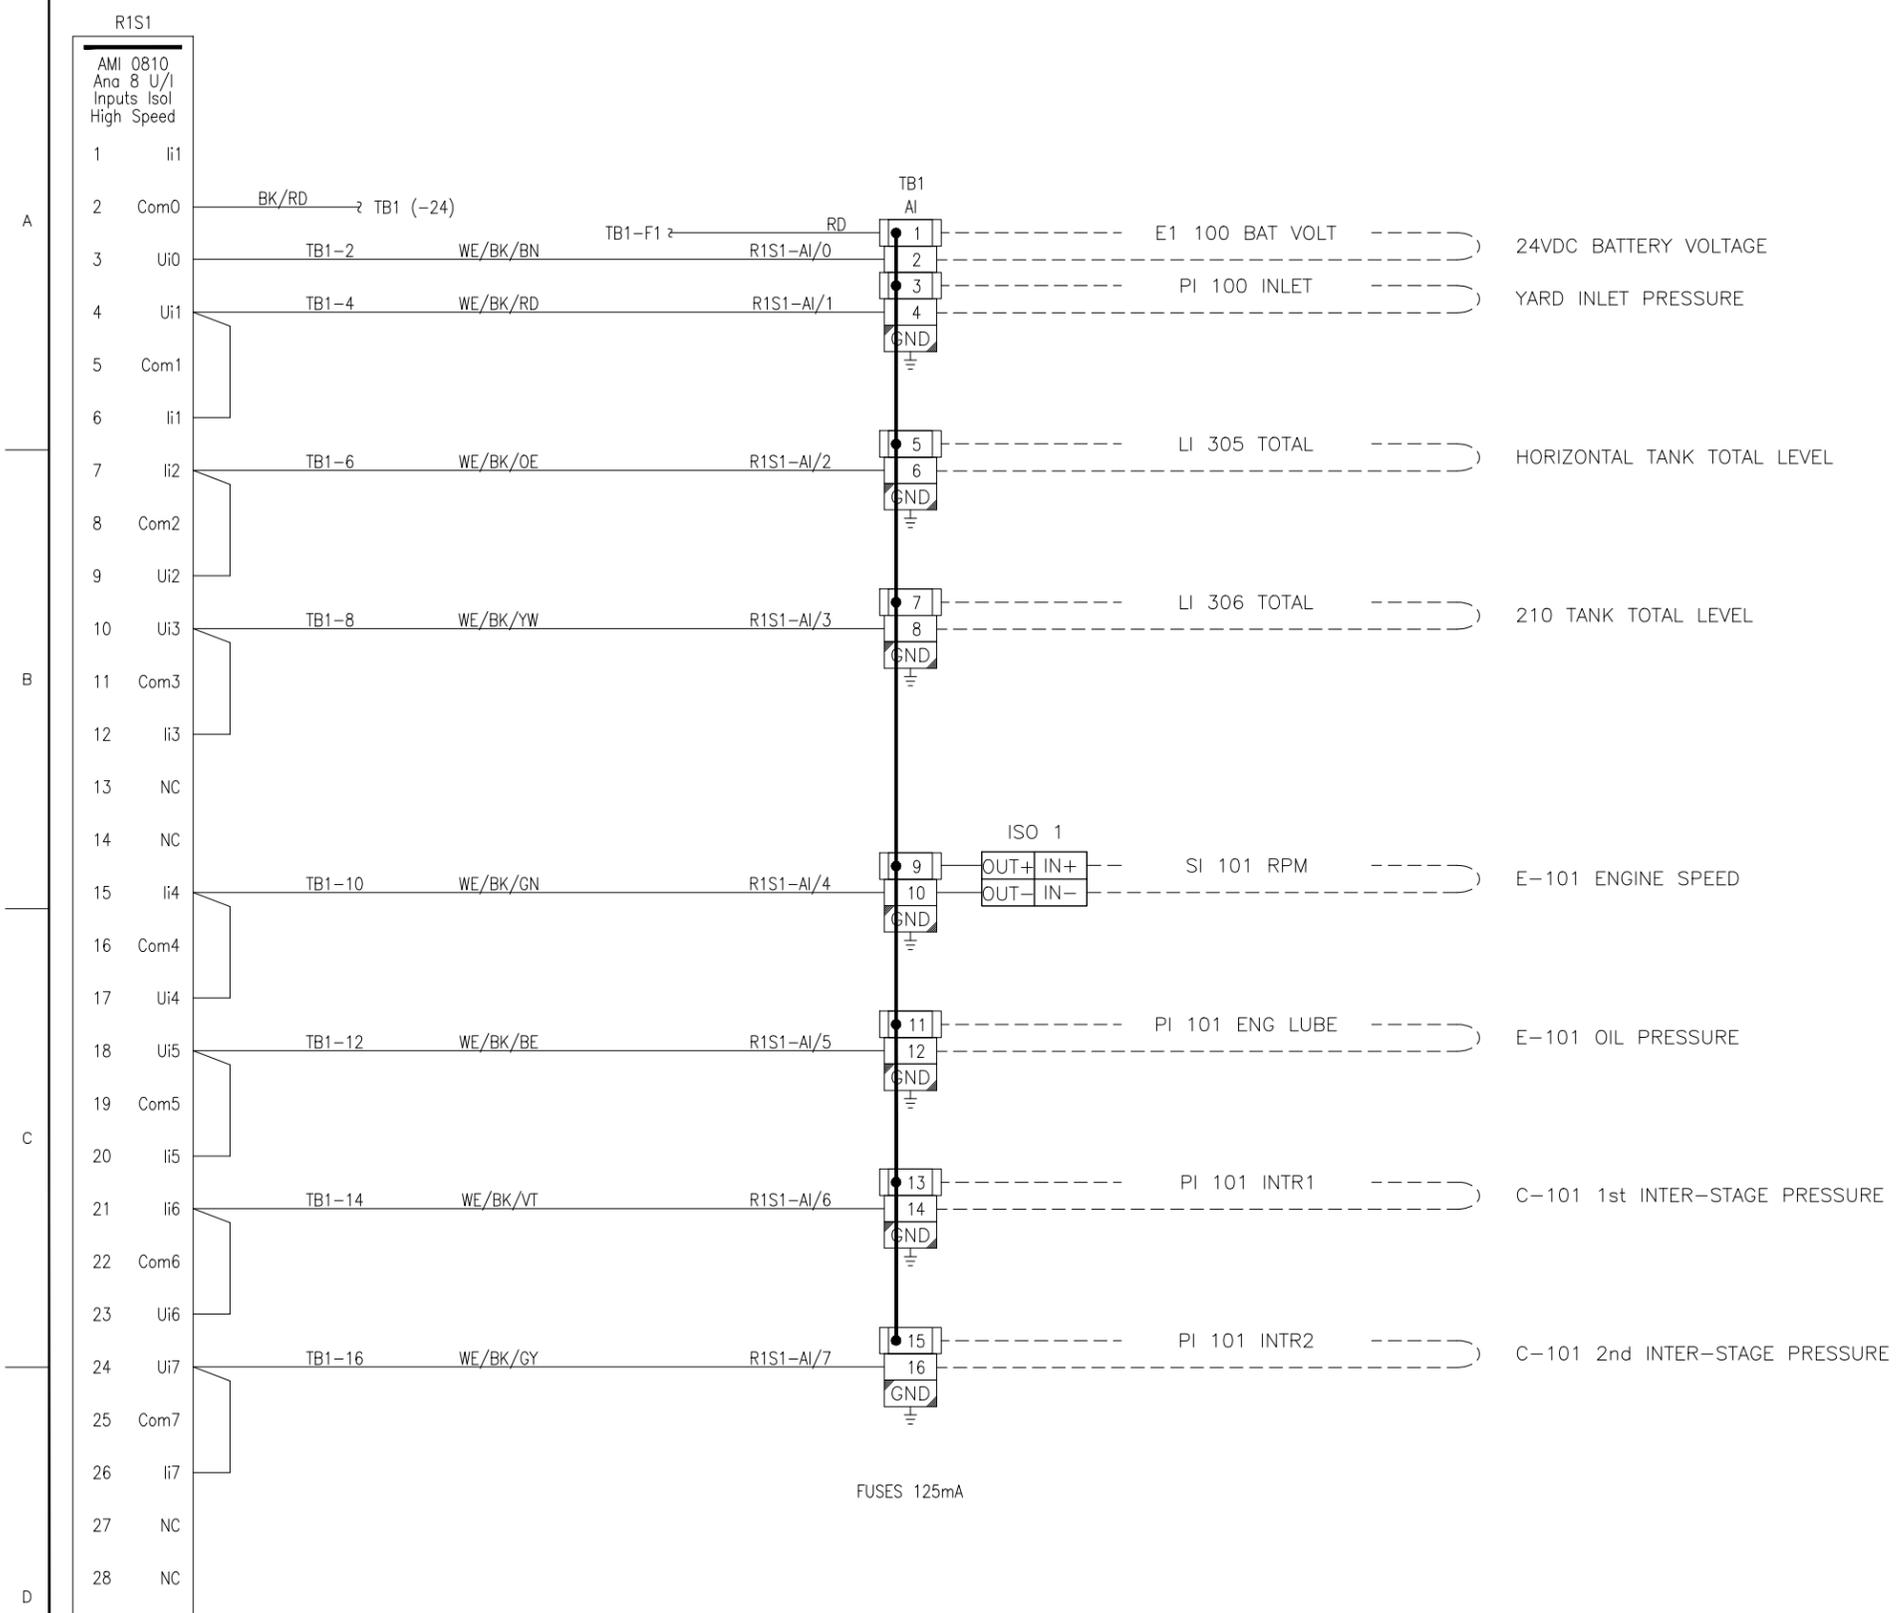

- R1S1
- AMI 0810
  - And 8 U/I
  - Inputs Isol
  - High Speed
- |    |      |
|----|------|
| 1  | li1  |
| 2  | Com0 |
| 3  | Ui0  |
| 4  | Ui1  |
| 5  | Com1 |
| 6  | li1  |
| 7  | li2  |
| 8  | Com2 |
| 9  | Ui2  |
| 10 | Ui3  |
| 11 | Com3 |
| 12 | li3  |
| 13 | NC   |
| 14 | NC   |
| 15 | li4  |
| 16 | Com4 |
| 17 | Ui4  |
| 18 | Ui5  |
| 19 | Com5 |
| 20 | li5  |
| 21 | li6  |
| 22 | Com6 |
| 23 | Ui6  |
| 24 | Ui7  |
| 25 | Com7 |
| 26 | li7  |
| 27 | NC   |
| 28 | NC   |

**KCI** Kelley's Controls, Inc.  
 210 E. 57th St. / P.O. Box 13807  
 Odessa, Texas 79768-3807  
 (432) 362-7998

DRAWING # TARG-D-007-03 WORK ORDER # 3498A

REFERENCE DRAWINGS:

NO.	DATE	REVISION	DRW.	DES.	CHK.	APP.	NO.	DATE	REVISION	DRW.	DES.	CHK.	APP.
							0	7/20/15	AS BUILT	JDC			



REAGAN COMPRESSOR STATION  
 SADN-3482  
 R1S1 / TB1

SCALE: NONE	PLOT SCALE:
A/E:	LOCATION:
DWG. NO: TARG-D-007-03	REV. 0

DWG NO.



R1S2

- AMI 0810
- Anal 8 U/I
- Inputs Isol
- High Speed
- 1 ii1
- 2 Com0
- 3 Ui0
- 4 Ui1
- 5 Com1
- 6 ii1
- 7 ii2
- 8 Com2
- 9 Ui2
- 10 Ui3
- 11 Com3
- 12 ii3
- 13 NC
- 14 NC
- 15 ii4
- 16 Com4
- 17 Ui4
- 18 Ui5
- 19 Com5
- 20 ii5
- 21 ii6
- 22 Com6
- 23 Ui6
- 24 Ui7
- 25 Com7
- 26 ii7
- 27 NC
- 28 NC

FUSES 125mA

**KCI** Kelley's Controls, Inc.  
 210 E. 57th St. / P.O. Box 13807  
 Odessa, Texas 79768-3807  
 (432) 362-7998

DRAWING # TARG-D-007-04 WORK ORDER # 3498A


REFERENCE DRAWINGS:				NO.	DATE	REVISION	DRW.	DES.	CHK.	APP.	NO.	DATE	REVISION	DRW.	DES.	CHK.	APP.	
												0	7/20/15	AS BUILT	JDC			



REAGAN COMPRESSOR STATION  
 SADN-3482  
 R1S2 / TB2

SCALE:	PLOT SCALE:
AFE:	LOCATION:
DWG. NO: TARG-D-007-04	REV. 0

DWG NO.

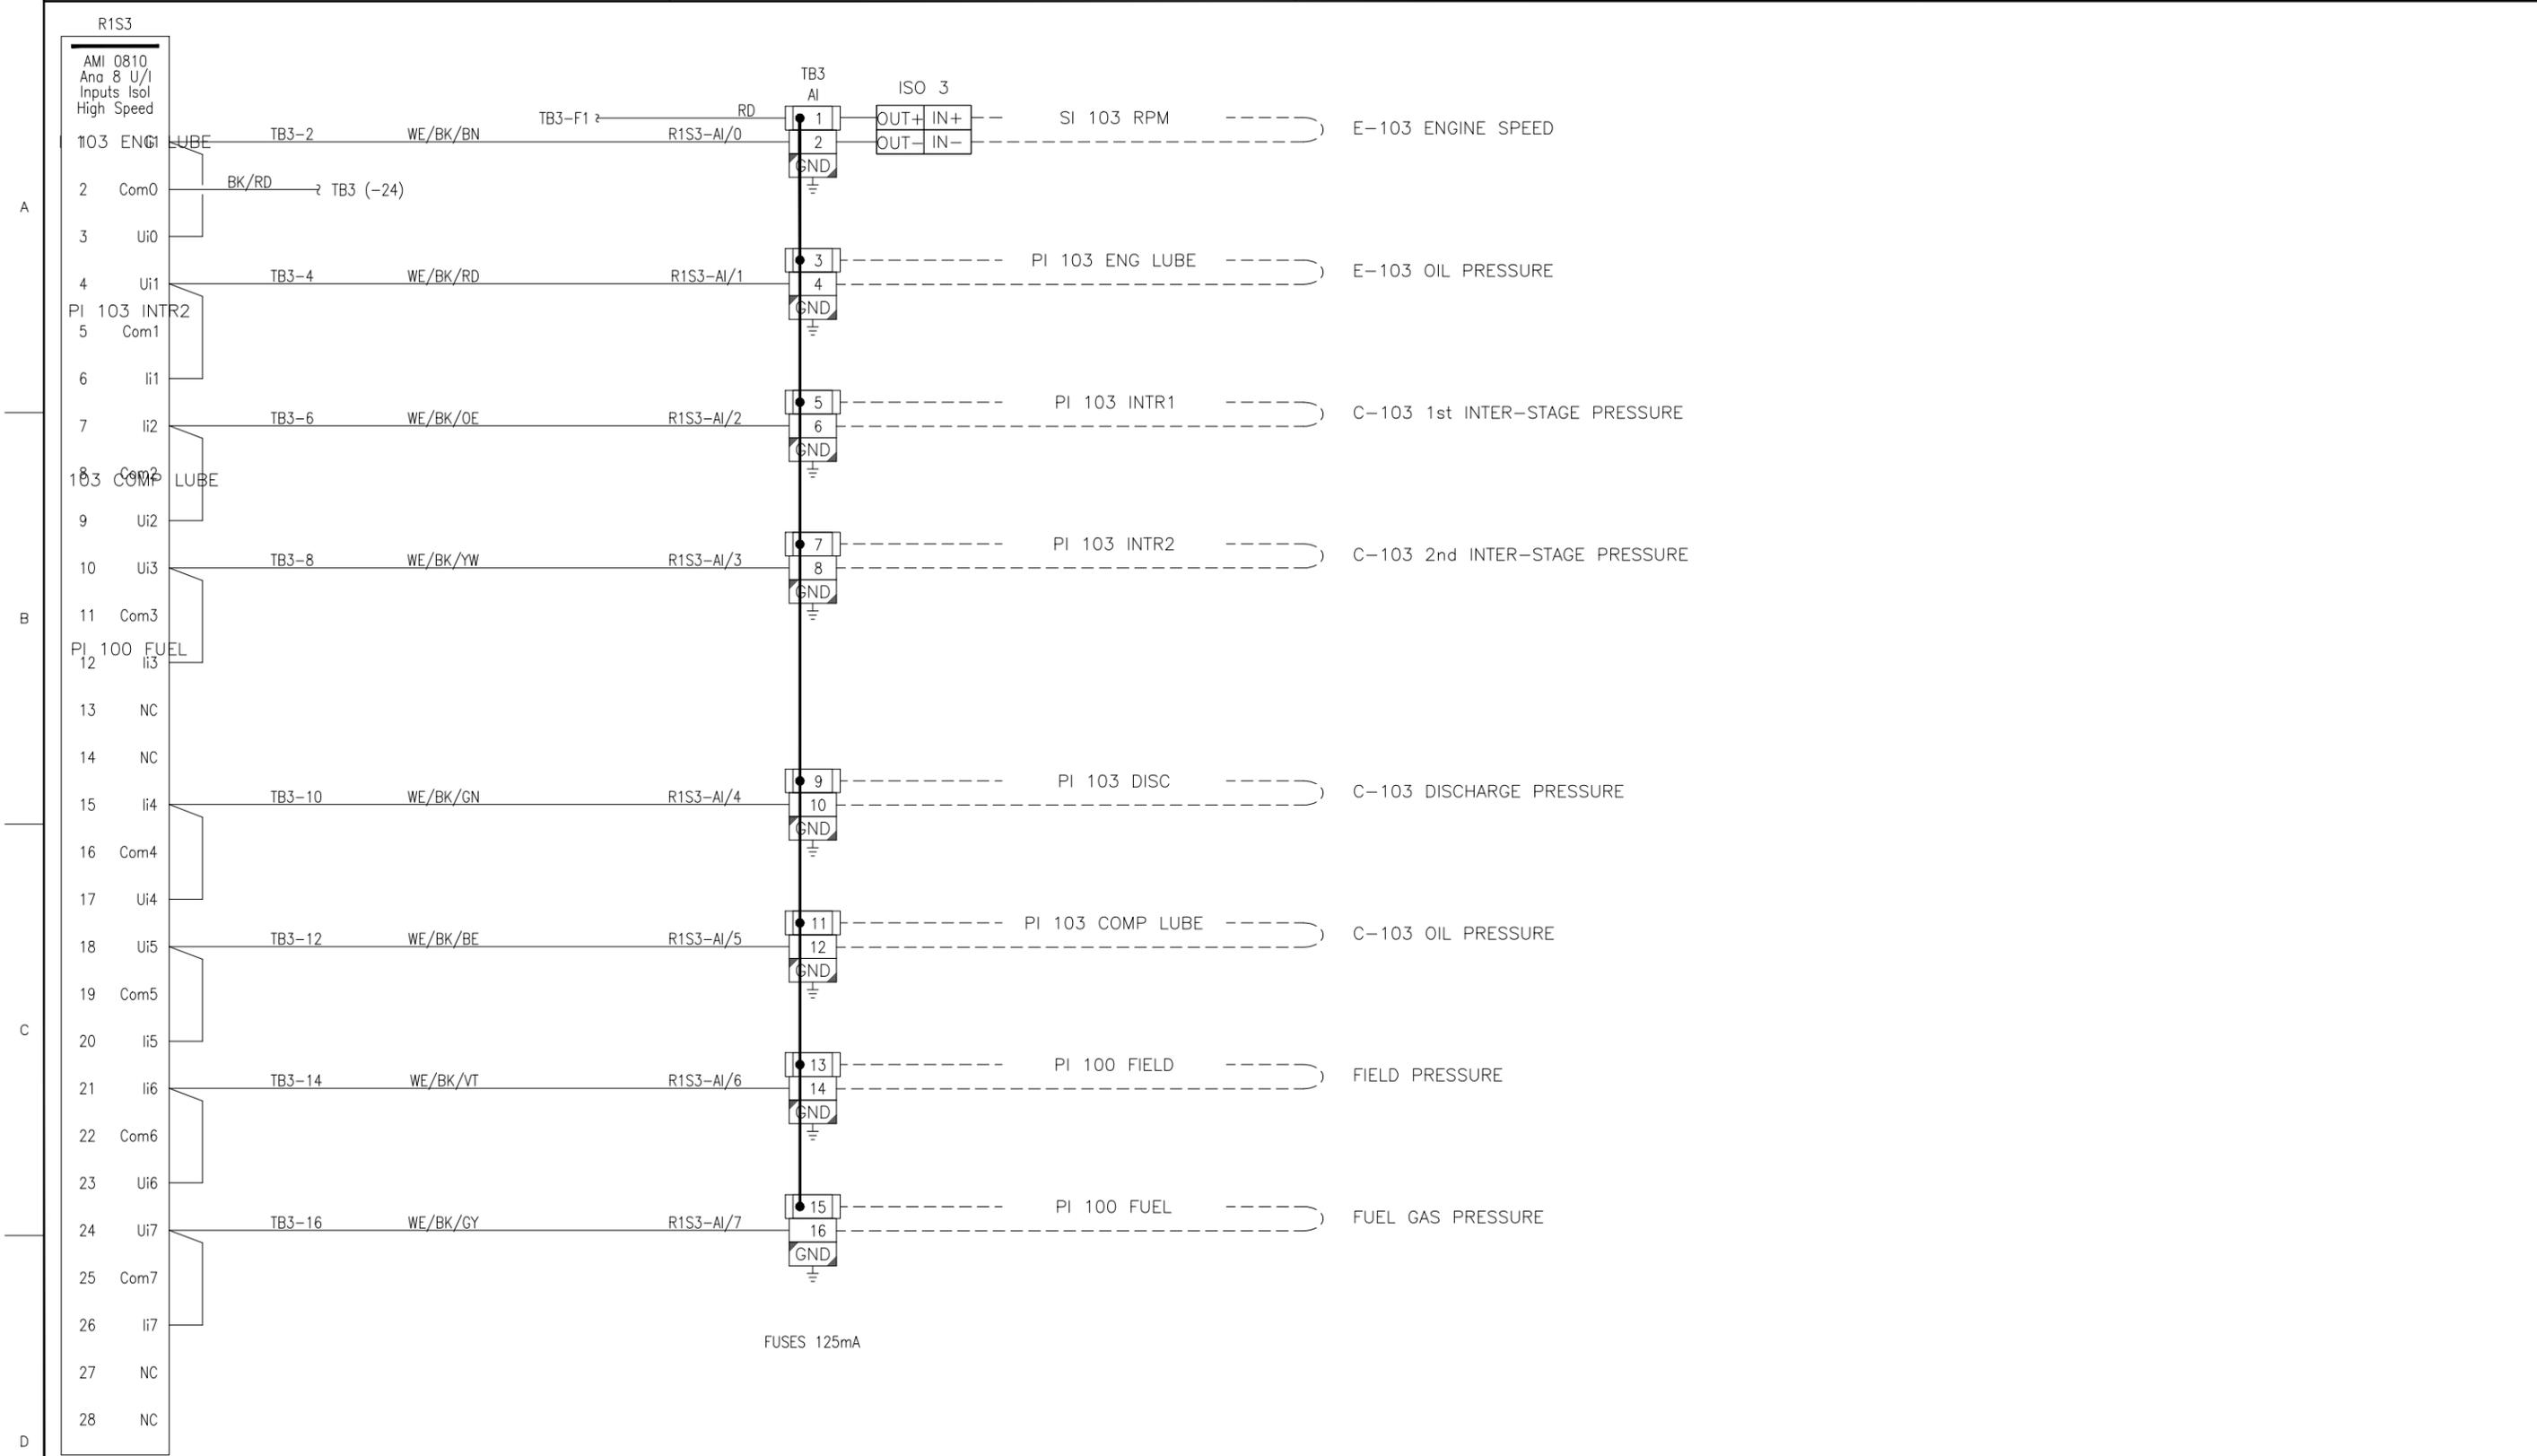

**KCI** Kelley's Controls, Inc.  
 210 E. 57th St. / P.O. Box 13807  
 Odessa, Texas 79768-3807  
 (432) 362-7998

DRAWING # TARG-D-007-05 WORK ORDER # 3498A

REFERENCE DRAWINGS:				NO.	DATE	REVISION	DRW.	DES.	CHK.	APP.	NO.	DATE	REVISION	DRW.	DES.	CHK.	APP.	
												0	7/20/15	AS BUILT	JDC			



REAGAN COMPRESSOR STATION  
 SADN-3482  
 R1S3 / TB3

SCALE:	PLOT SCALE:
AFE:	LOCATION:
DWG. NO: TARG-D-007-05	REV. 0

DWG. NO.






A

B

C

D

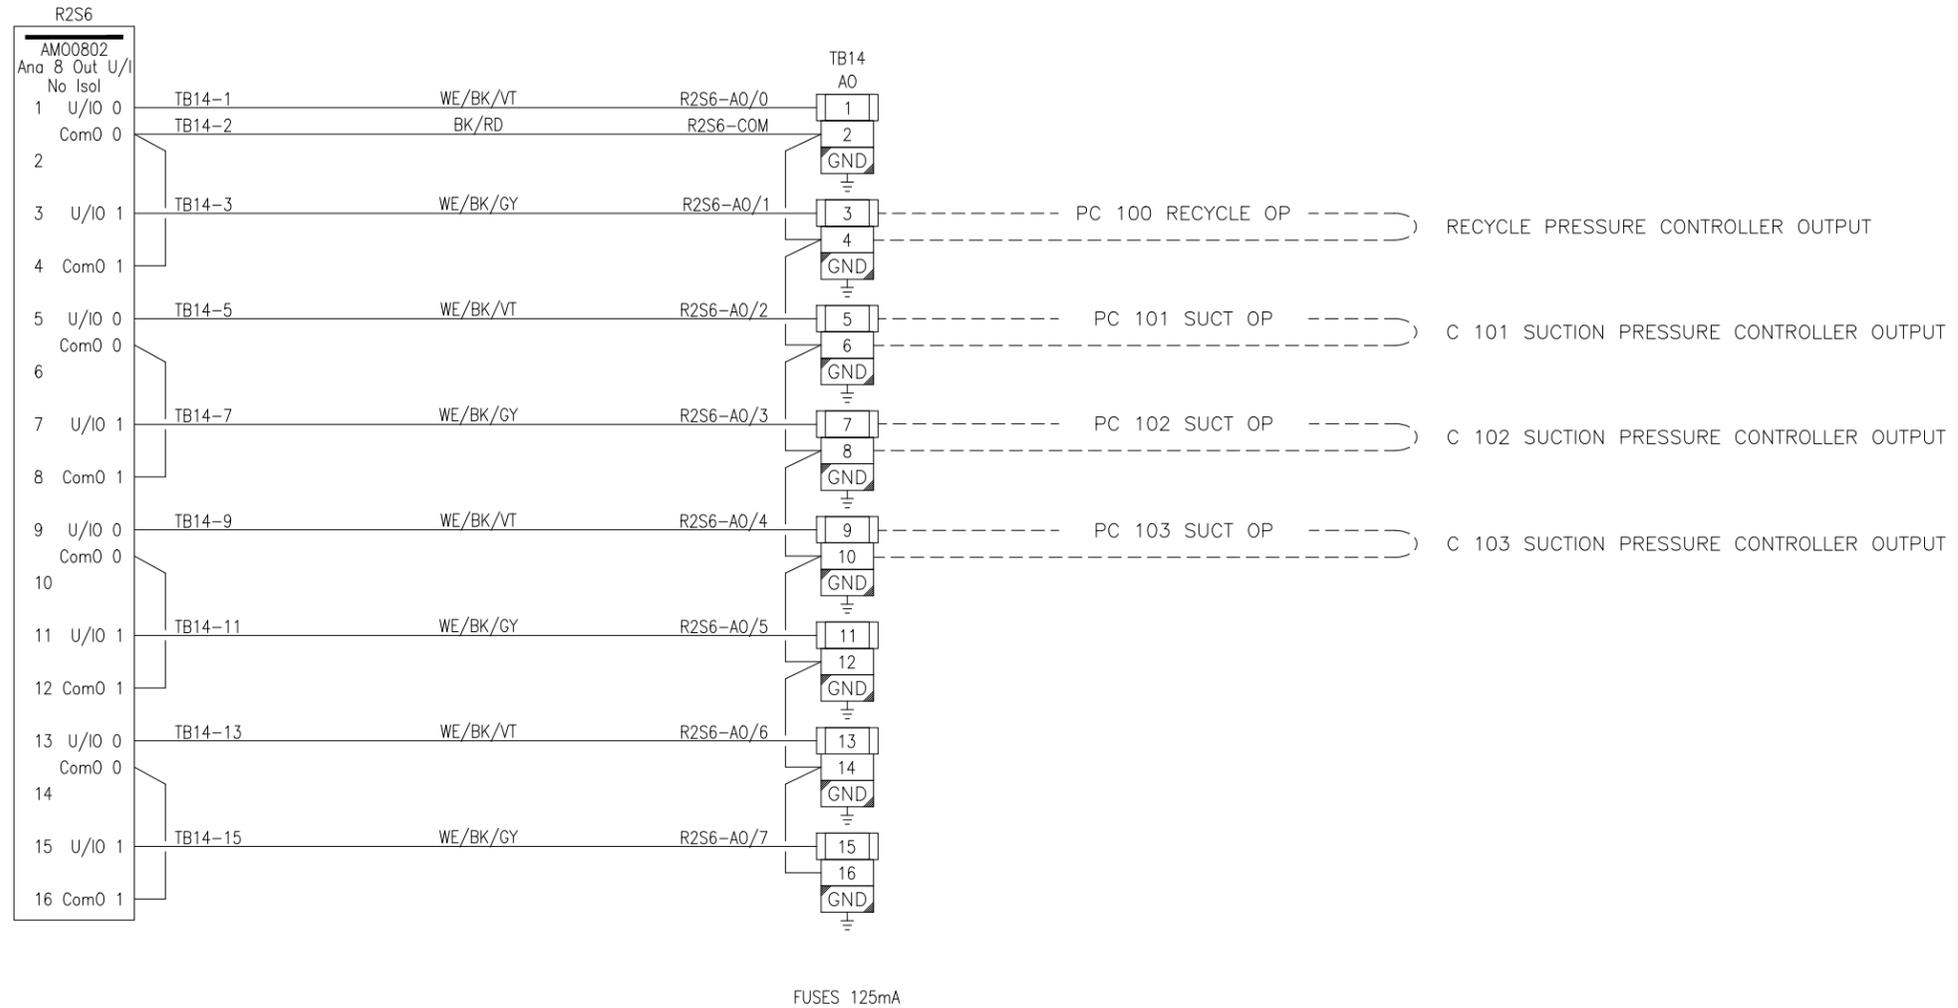

**KCI** Kelley's Controls, Inc.  
 210 E. 57th St. / P.O. Box 13807  
 Odessa, Texas 79768-3807  
 (432) 362-7998

DRAWING # TARG-D-007-08 WORK ORDER # 3498A

REFERENCE DRAWINGS:

NO.	DATE	REVISION	DRW.	DES.	CHK.	APP.	NO.	DATE	REVISION	DRW.	DES.	CHK.	APP.
							0	7/20/15	AS BUILT	JDC			



REAGAN COMPRESSOR STATION  
 SADN-3482  
 R2S6 / TB14

SCALE:	PLOT SCALE:
AFE:	LOCATION:
DWG. NO: TARG-D-007-08	REV. 0


DWG NO.

A

B

C

D

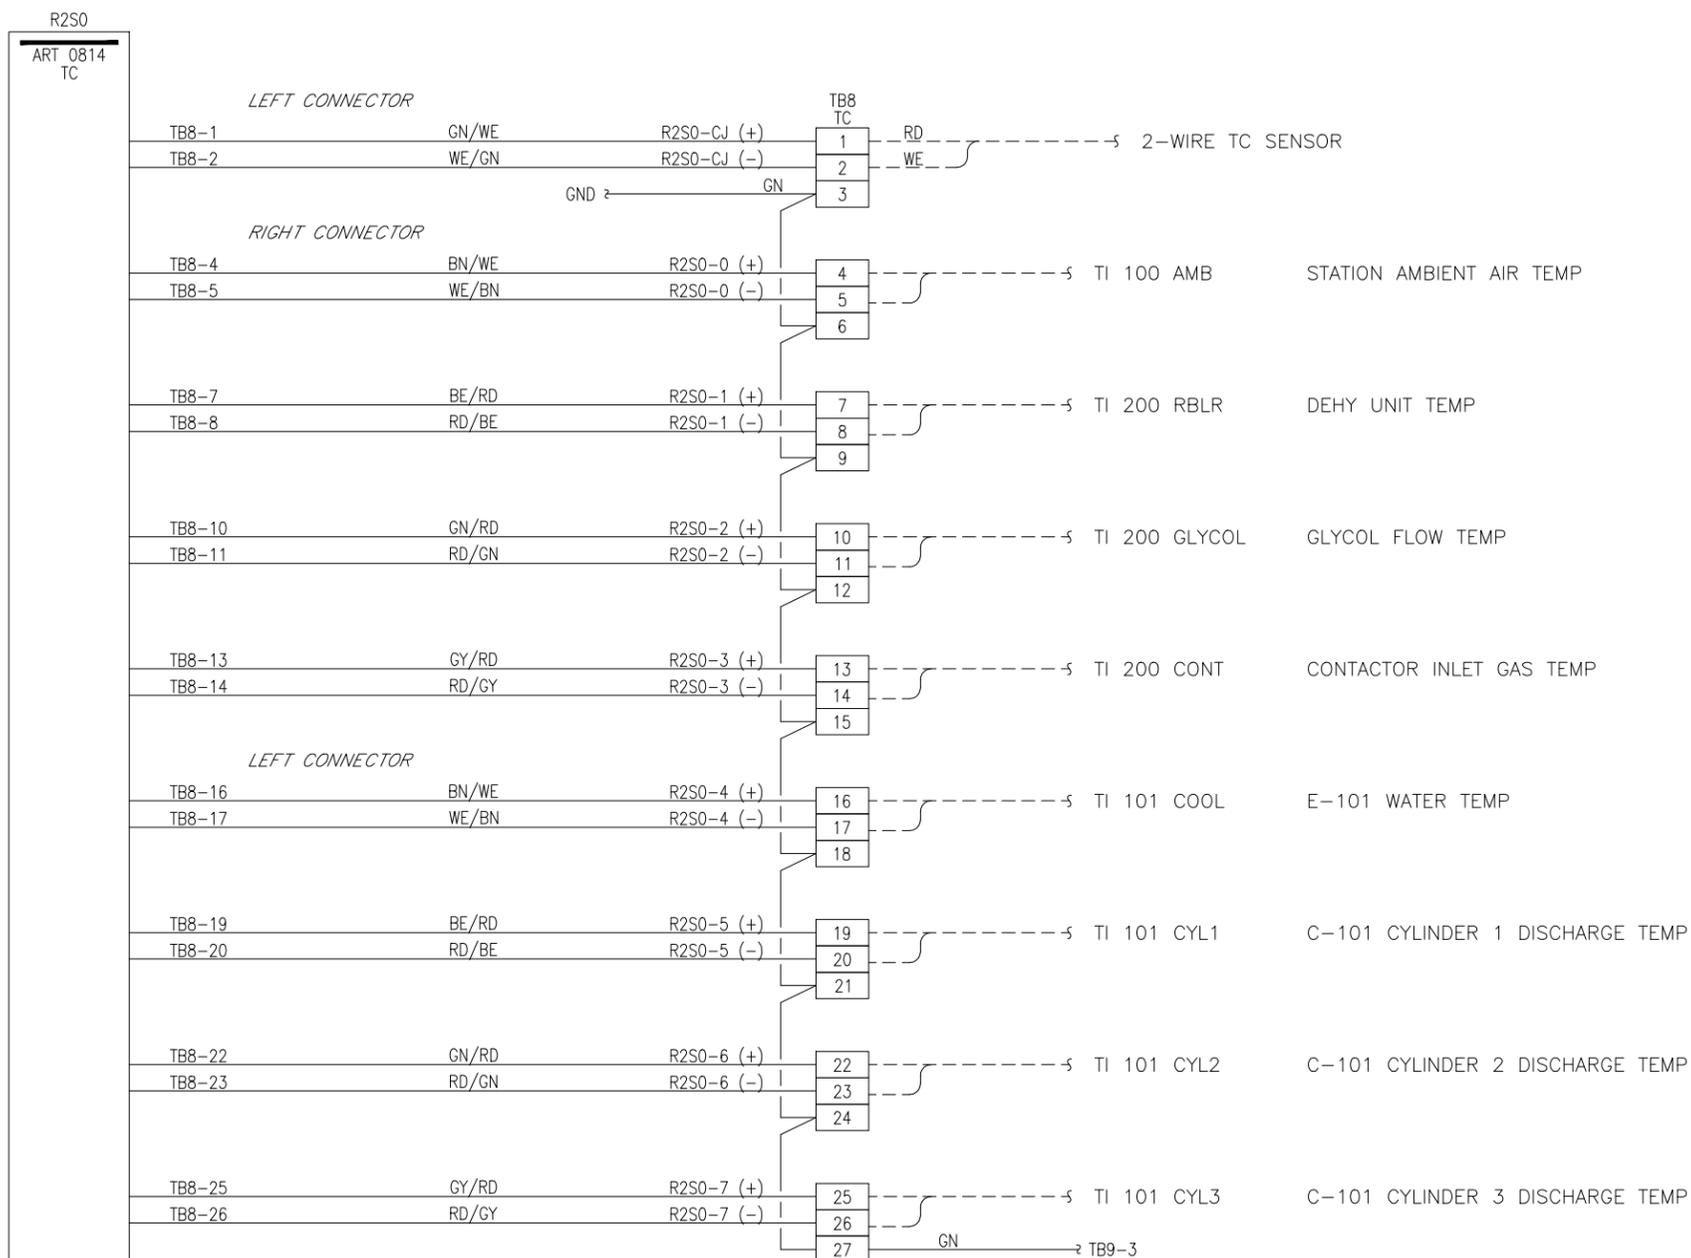

**KCI** Kelley's Controls, Inc.  
210 E. 57th St. / P.O. Box 13807  
Odessa, Texas 79768-3807  
(432) 362-7998

DRAWING # TARG-D-007-07 WORK ORDER # 3498A

REFERENCE DRAWINGS:

NO.	DATE	REVISION	DRW.	DES.	CHK.	APP.	NO.	DATE	REVISION	DRW.	DES.	CHK.	APP.
							0	7/20/15	AS BUILT	JDC			



REAGAN COMPRESSOR STATION  
SADN-3482  
R2S0 / TB8

SCALE:	PLOT SCALE:
AFE:	LOCATION:
DWG. NO: TARG-D-007-09	REV. 0

DWG. NO.



R2S2  
ART 0814  
TC

LEFT CONNECTOR



TB10 TC  
1 RD  
2 WE  
3

2-WIRE TC SENSOR

RIGHT CONNECTOR



4  
5  
6  
7  
8  
9

TI 103 COOL E-103 WATER TEMP




7  
8  
9  
10  
11  
12

TI 103 CYL1 C-103 CYLINDER 1 DISCHARGE TEMP



10  
11  
12  
13  
14  
15

TI 103 CYL2 C-103 CYLINDER 2 DISCHARGE TEMP

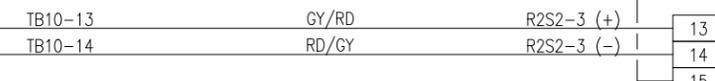

13  
14  
15  
16  
17  
18

TI 103 CYL3 C-103 CYLINDER 3 DISCHARGE TEMP

LEFT CONNECTOR




16  
17  
18  
19  
20  
21

TI 103 CYL4 C-103 CYLINDER 4 DISCHARGE TEMP



19  
20  
21  
22  
23  
24

TI 103 COMP OIL C-103 COMPRESSOR OIL TEMP

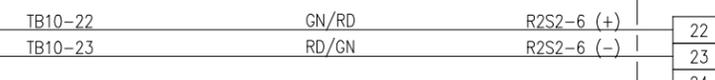

22  
23  
24  
25  
26  
27

TI 420 DISC FUEL CONDITIONER FUEL OUTLET TEMP



25  
26  
27

TI 420 LP SEP FUEL CONDITIONER LP SEP TEMP



**KCI** Kelley's Controls, Inc.  
210 E. 57th St. / P.O. BOX 13807  
ODessa, TEXAS 79168-3807  
(432) 362-7998

DRAWING # TARG-D-007-11 WORK ORDER # 3498A

REFERENCE DRAWINGS:

NO.	DATE	REVISION	DRW.	DES.	CHK.	APP.	NO.	DATE	REVISION	DRW.	DES.	CHK.	APP.
							0	7/20/15	AS BUILT	JDC			



REAGAN COMPRESSOR STATION  
SADN-3482  
R2S2 / TB10

SCALE:	PLOT SCALE:
AFE:	LOCATION:
DWG. NO: TARG-D-007-11	REV. 0

DWG NO.

R2S3


ART 0814  
TC

LEFT CONNECTOR



2-WIRE TC SENSOR

RIGHT CONNECTOR

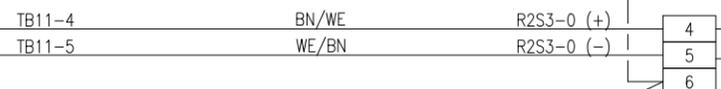


SPARE



SPARE



SPARE

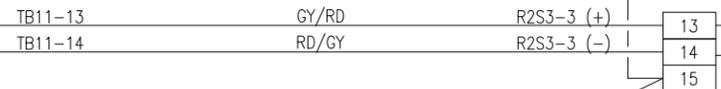


SPARE


LEFT CONNECTOR




SPARE

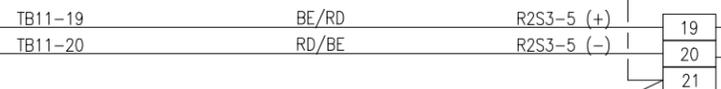

SPARE

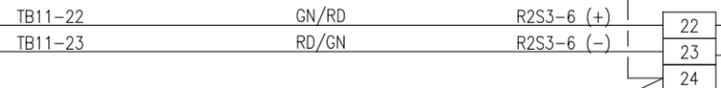

SPARE

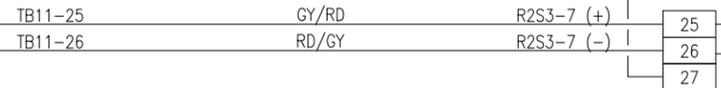

SPARE

**KCI** Kelley's Controls, Inc.  
210 E. 57th St. / P.O. Box 13807  
Odessa, Texas 79768-3807  
(432) 362-7998

DRAWING # TARG-D-007-12 WORK ORDER # 3498A

REFERENCE DRAWINGS:


NO.	DATE	REVISION	DRW.	DES.	CHK.	APP.	NO.	DATE	REVISION	DRW.	DES.	CHK.	APP.
							0	7/20/15	AS BUILT	JDC			



REAGAN COMPRESSOR STATION  
SADN-3482  
R2S3 / TB11

SCALE:	PLOT SCALE:
AFE:	LOCATION:
DWG. NO: TARG-D-007-12	REV. 0

DWG NO.

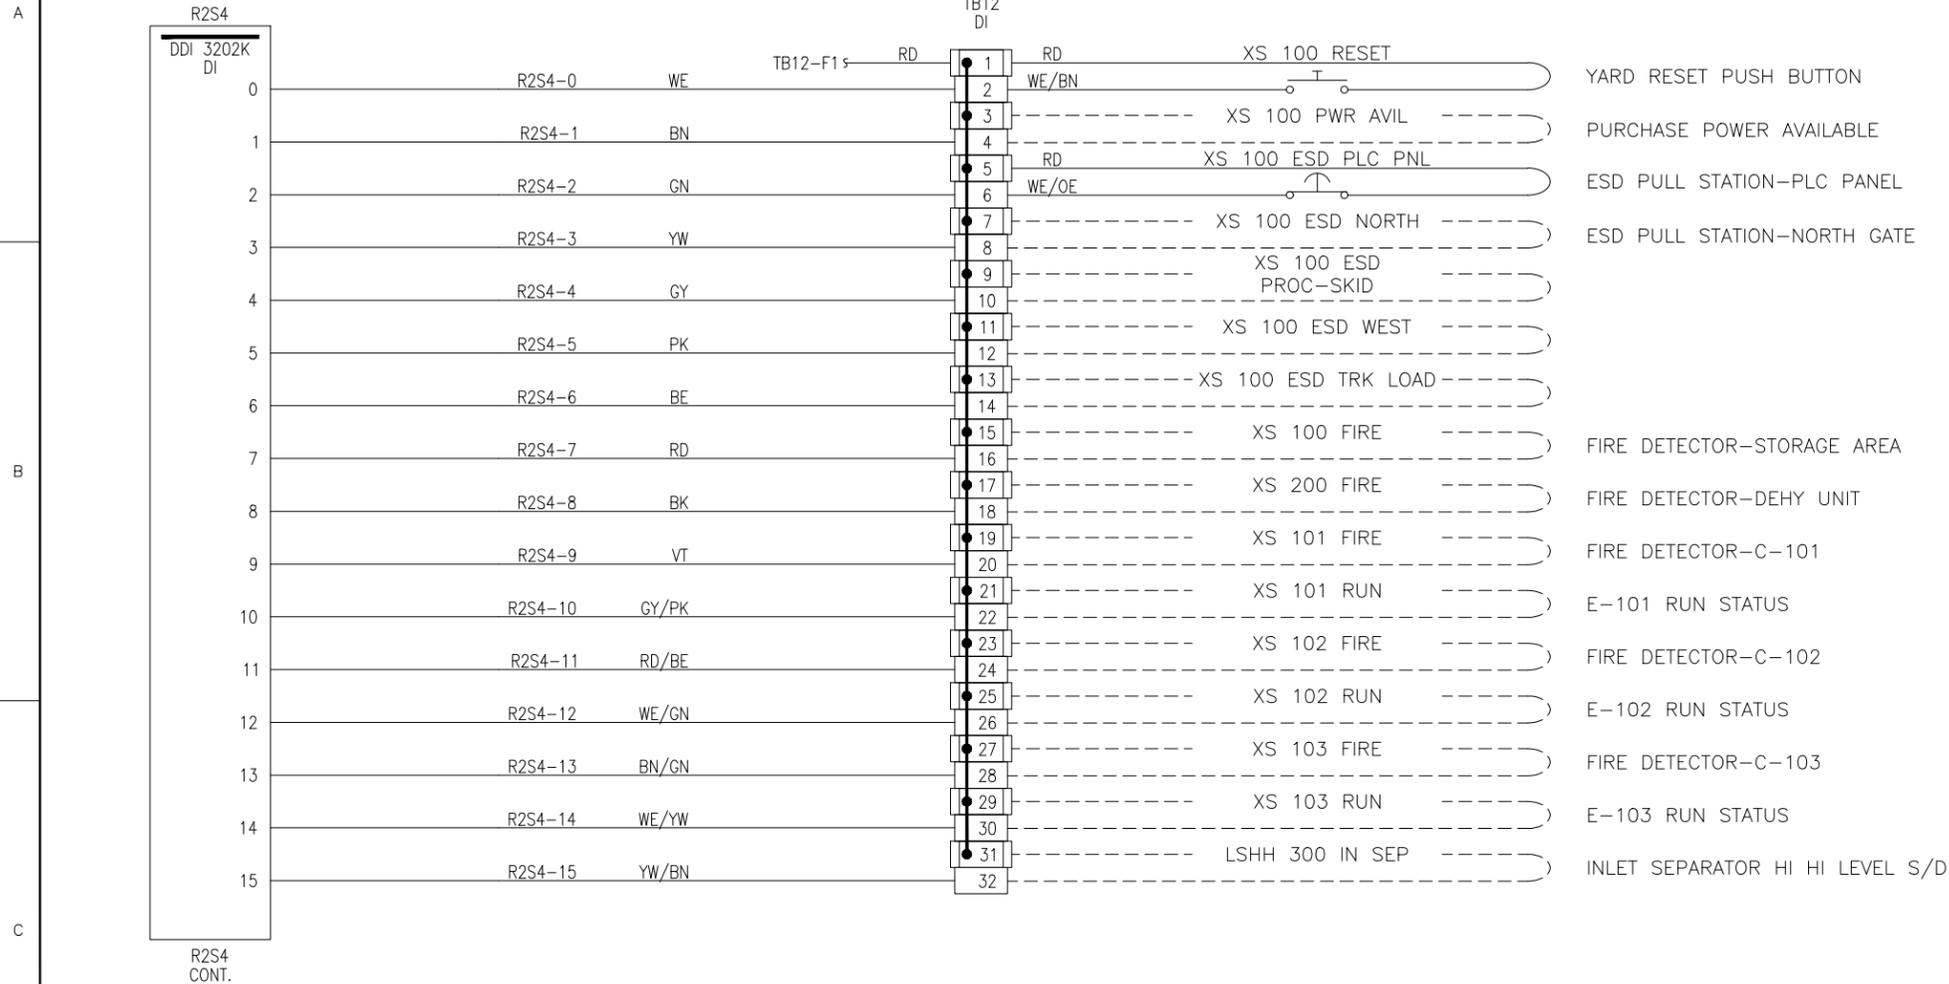

**KCI** Kelley's Controls, Inc.  
 210 E. 57th St. / P.O. Box 13807  
 Odessa, Texas 79768-3807  
 (432) 362-7998

DRAWING # TARG-D-006-11 WORK ORDER # 3424A

REFERENCE DRAWINGS:

NO.	DATE	REVISION	DRW.	DES.	CHK.	APP.	NO.	DATE	REVISION	DRW.	DES.	CHK.	APP.
							0	7/20/15	AS BUILT	JDC			



REAGAN COMPRESSOR STATION  
 SADN-3482  
 R2S4 (0-15) / TB12 (1-32)

SCALE:	PLOT SCALE:
AFE:	LOCATION:
DWG. NO: TARG-D-007-13	REV. 0


DWG NO.

A

B

C

D

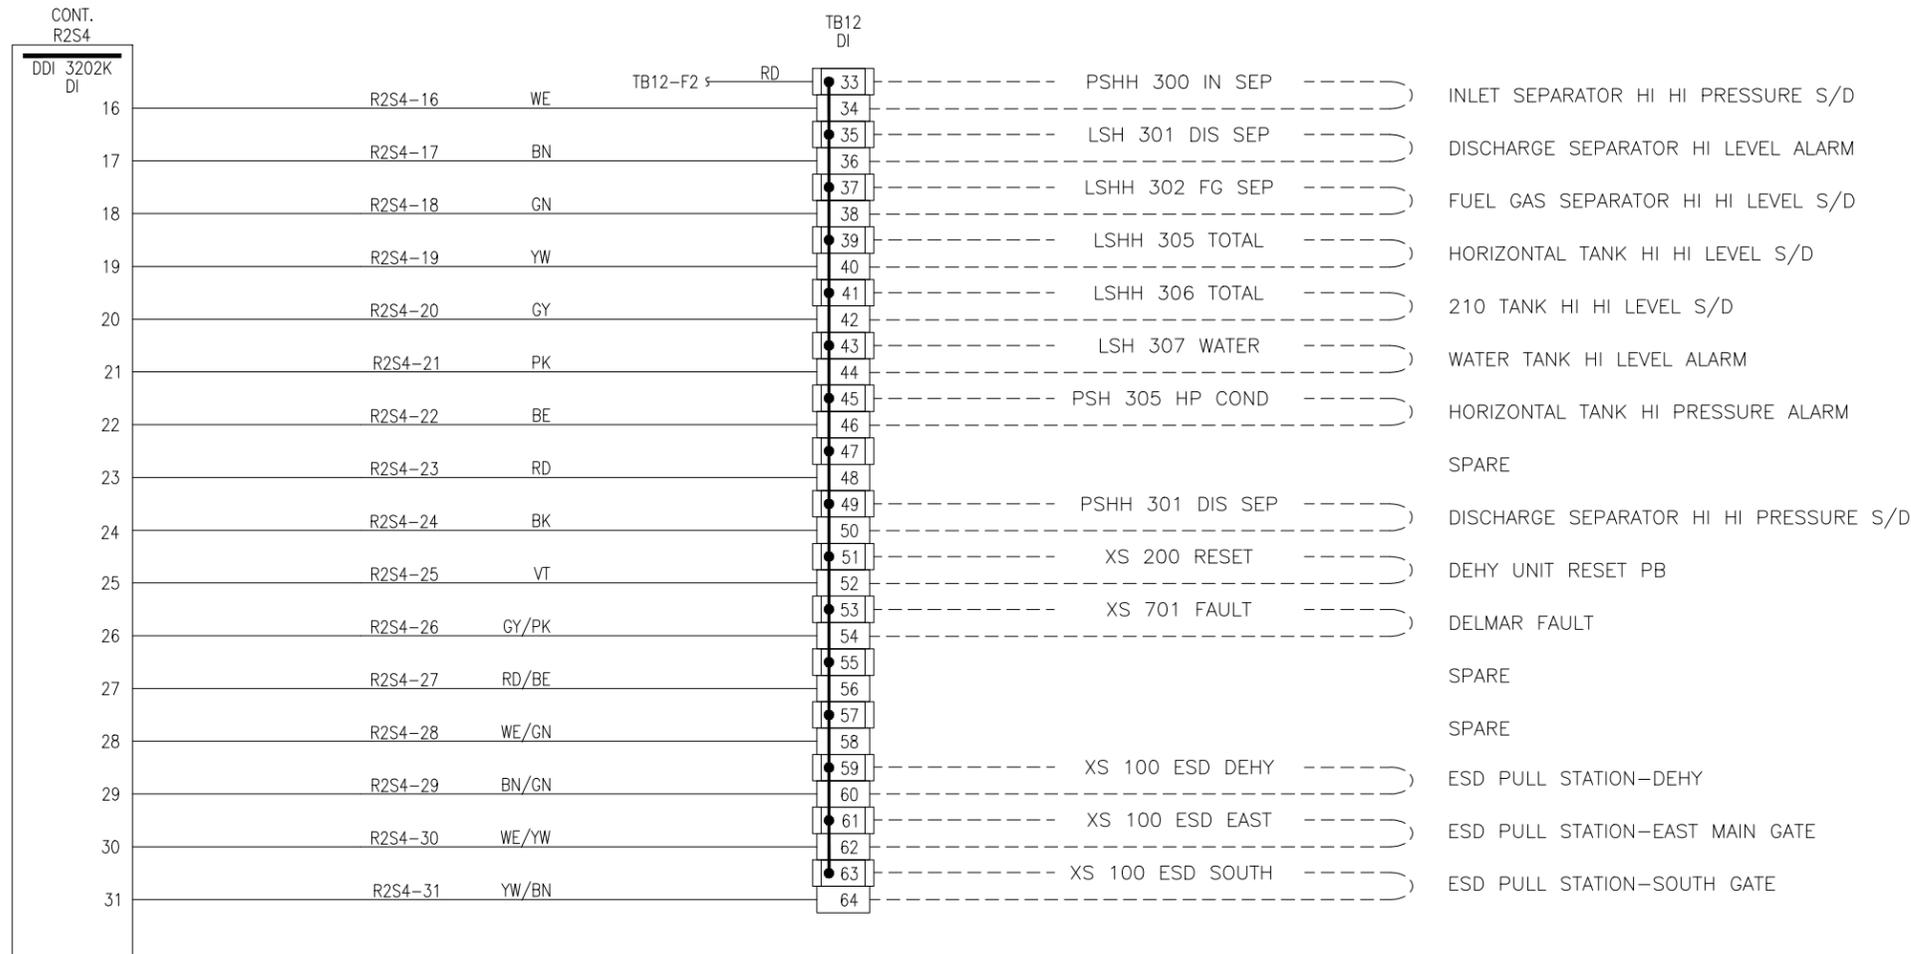

**KCI** Kelley's Controls, Inc.  
210 E. 57th St. / P.O. Box 13807  
Odessa, Texas 79768-3807  
(432) 362-7998

DRAWING # TARG-D-007-14 WORK ORDER # 3498A

REFERENCE DRAWINGS:

NO.	DATE	REVISION	DRW.	DES.	CHK.	APP.	NO.	DATE	REVISION	DRW.	DES.	CHK.	APP.
							0	7/20/15	AS BUILT	JDC			



REAGAN COMPRESSOR STATION  
SADN-3482  
R2S4 (16-31) / TB12 (33-64)

SCALE:	PLOT SCALE:
AFE:	LOCATION:
DWG. NO: TARG-D-007-14	REV. 0


DWG NO.

A

B

C

D

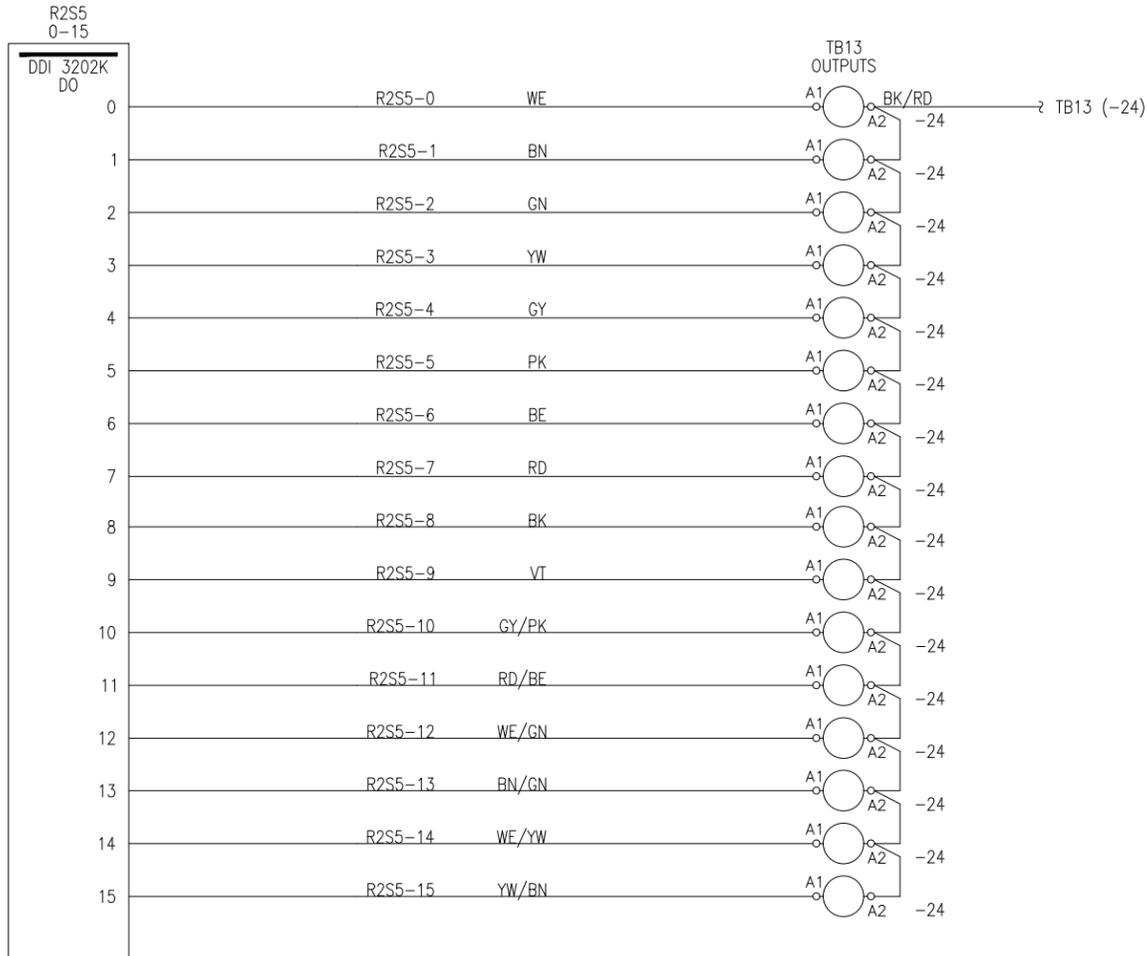

**KCI** Kelley's Controls, Inc.  
 210 E. 57th St. / P.O. Box 13807  
 Odessa, Texas 79768-3807  
 (432) 362-7998

DRAWING # TARG-D-007-15 WORK ORDER # 3498A

REFERENCE DRAWINGS:

NO.	DATE	REVISION	DRW.	DES.	CHK.	APP.	NO.	DATE	REVISION	DRW.	DES.	CHK.	APP.
							0	7/20/15	AS BUILT	JDC			



REAGAN COMPRESSOR STATION  
 SADN-3482  
 R2S5 (0-15) / TB13 OUTPUTS

SCALE:	PLOT SCALE:
AFE:	LOCATION:
DWG. NO: TARG-D-007-15	REV. 0


DWG NO.

A

B

C

D

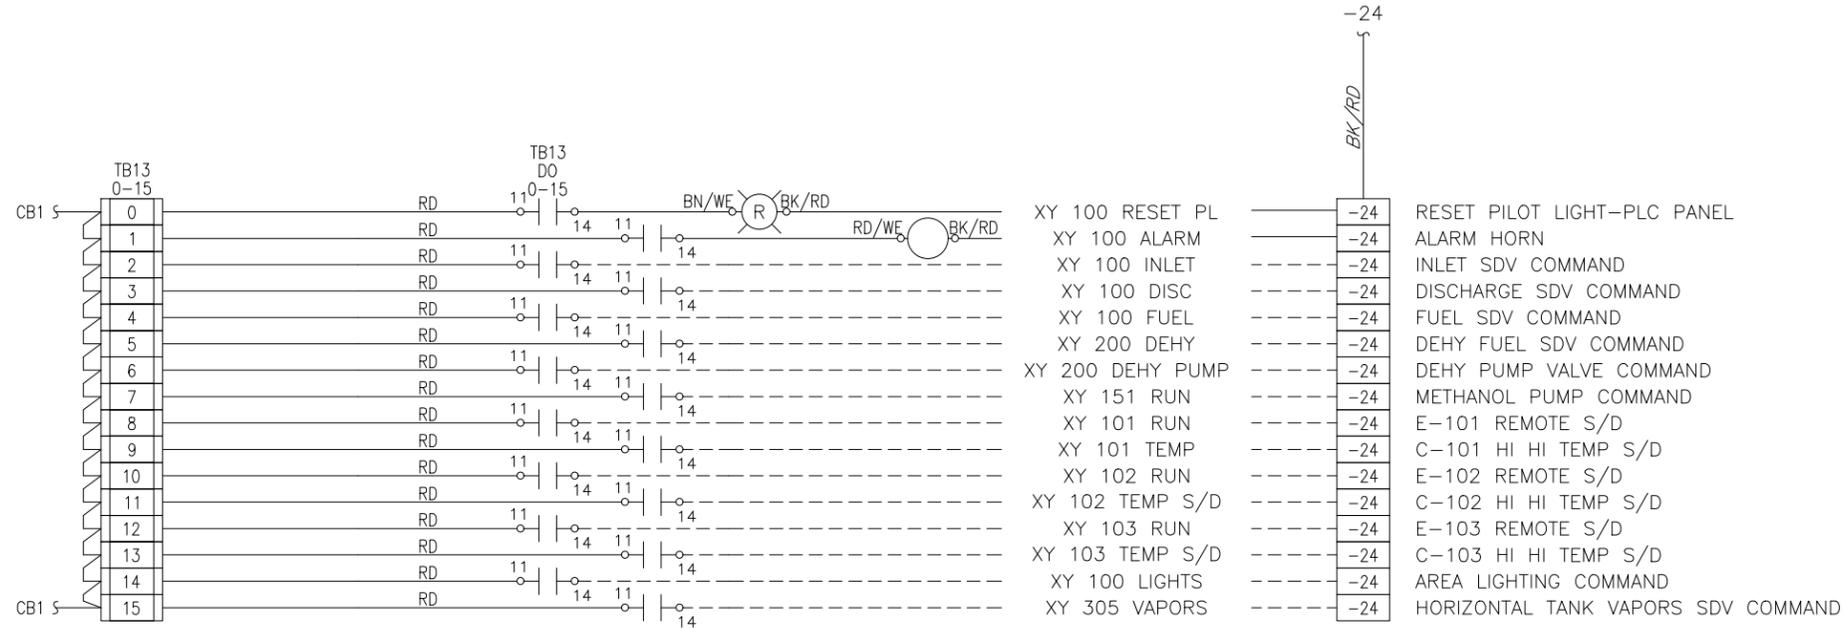

**KCI** Kelley's Controls, Inc.  
 210 E. 57th St. / P.O. Box 13807  
 Odessa, Texas 79768-3807  
 (432) 362-7998

DRAWING # TARG-D-007-16 WORK ORDER # 3498A

REFERENCE DRAWINGS:

NO.	DATE	REVISION	DRW.	DES.	CHK.	APP.	NO.	DATE	REVISION	DRW.	DES.	CHK.	APP.
							0	7/20/15	AS BUILT	JDC			



REAGAN COMPRESSOR STATION  
 SADN-3482  
 TB13 0-15

SCALE:	PLOT SCALE:
AFE:	LOCATION:
DWG. NO: TARG-D-007-16	REV. 0


DWG NO.

A

B

C

D

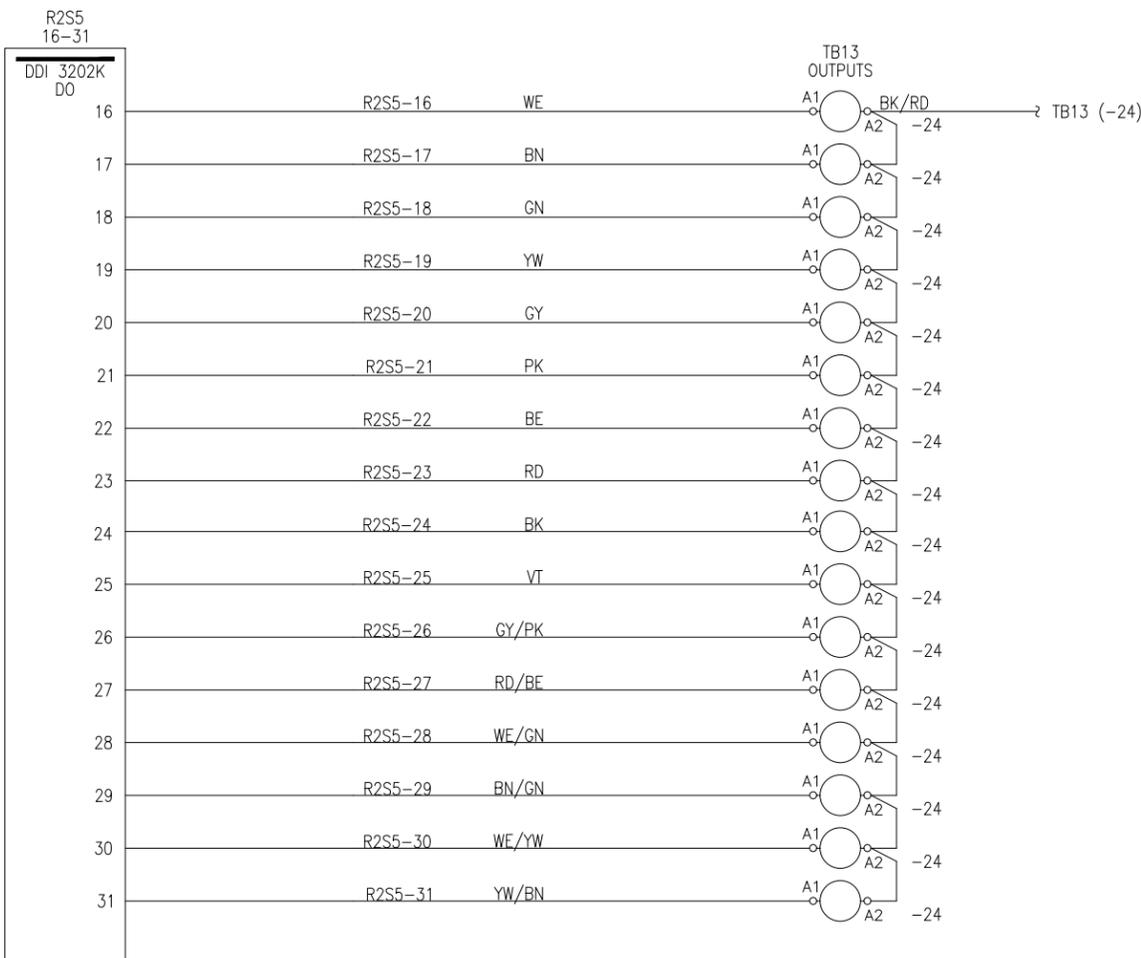

**KCI** Kelley's Controls, Inc.  
210 E. 57th St. / P.O. Box 13807  
Odessa, Texas 79768-3807  
(432) 362-7998

DRAWING # TARG-D-007-17 WORK ORDER # 3498A

REFERENCE DRAWINGS:

NO.	DATE	REVISION	DRW.	DES.	CHK.	APP.	NO.	DATE	REVISION	DRW.	DES.	CHK.	APP.
							0	7/20/15	AS BUILT	JDC			



LAZY E COMPRESSOR STATION  
SADN-3755  
R2S5 (16-31) / TB13 OUTPUTS

SCALE:	PLOT SCALE:
AFE:	LOCATION:
DWG. NO: TARG-D-007-17	REV. 0


DWG NO.

A

B

C

D

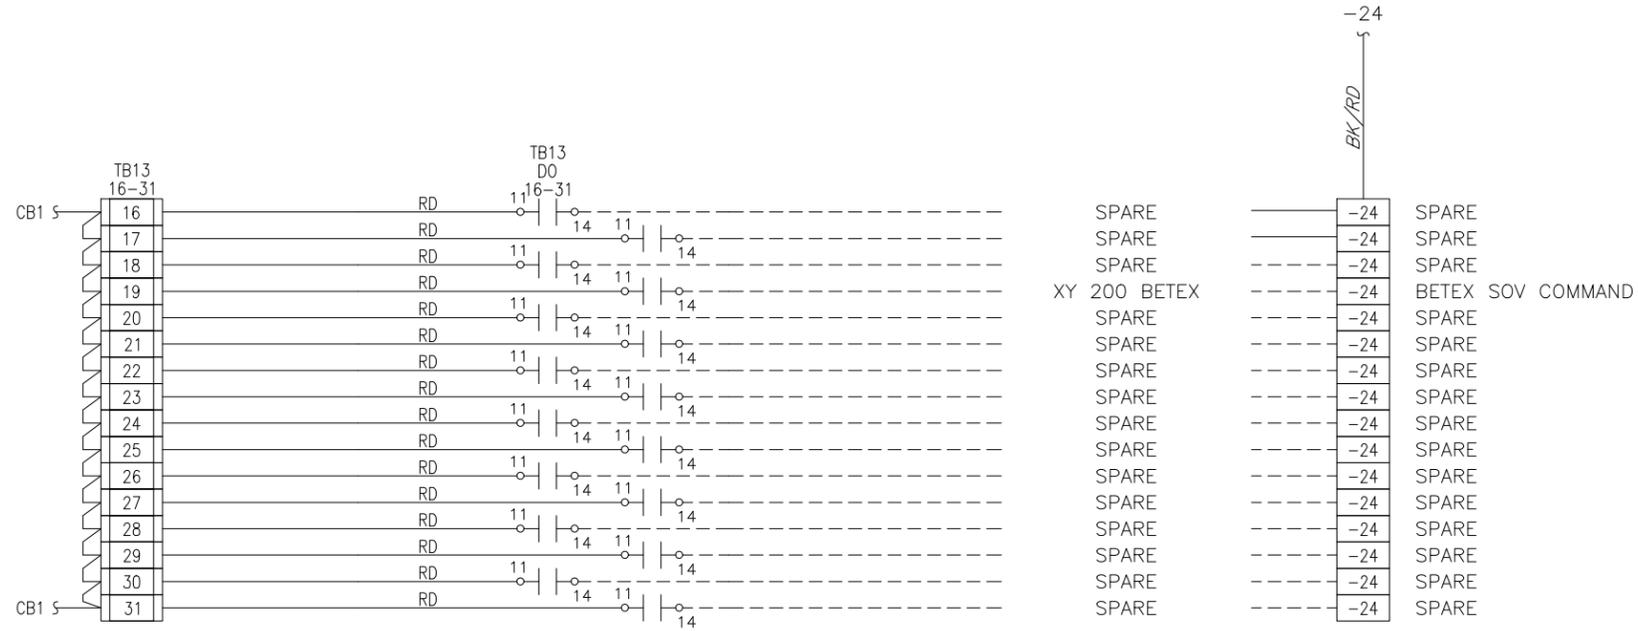

**KCI** Kelley's Controls, Inc.  
 210 E. 57th St. / P.O. Box 13807  
 Odessa, Texas 79768-3807  
 (432) 362-7998

DRAWING # TARG-D-007-18 WORK ORDER # 3498A

REFERENCE DRAWINGS:

NO.	DATE	REVISION	DRW.	DES.	CHK.	APP.	NO.	DATE	REVISION	DRW.	DES.	CHK.	APP.
							0	7/20/15	AS BUILT	JDC			



LAZY E COMPRESSOR STATION  
 SADN-3755  
 TB13 (16-31)

SCALE:	PLOT SCALE:
AFE:	LOCATION:
DWG. NO: TARG-D-007-18	REV. 0

DWG NO.

